



LEFT SIDE  
SUBPANEL

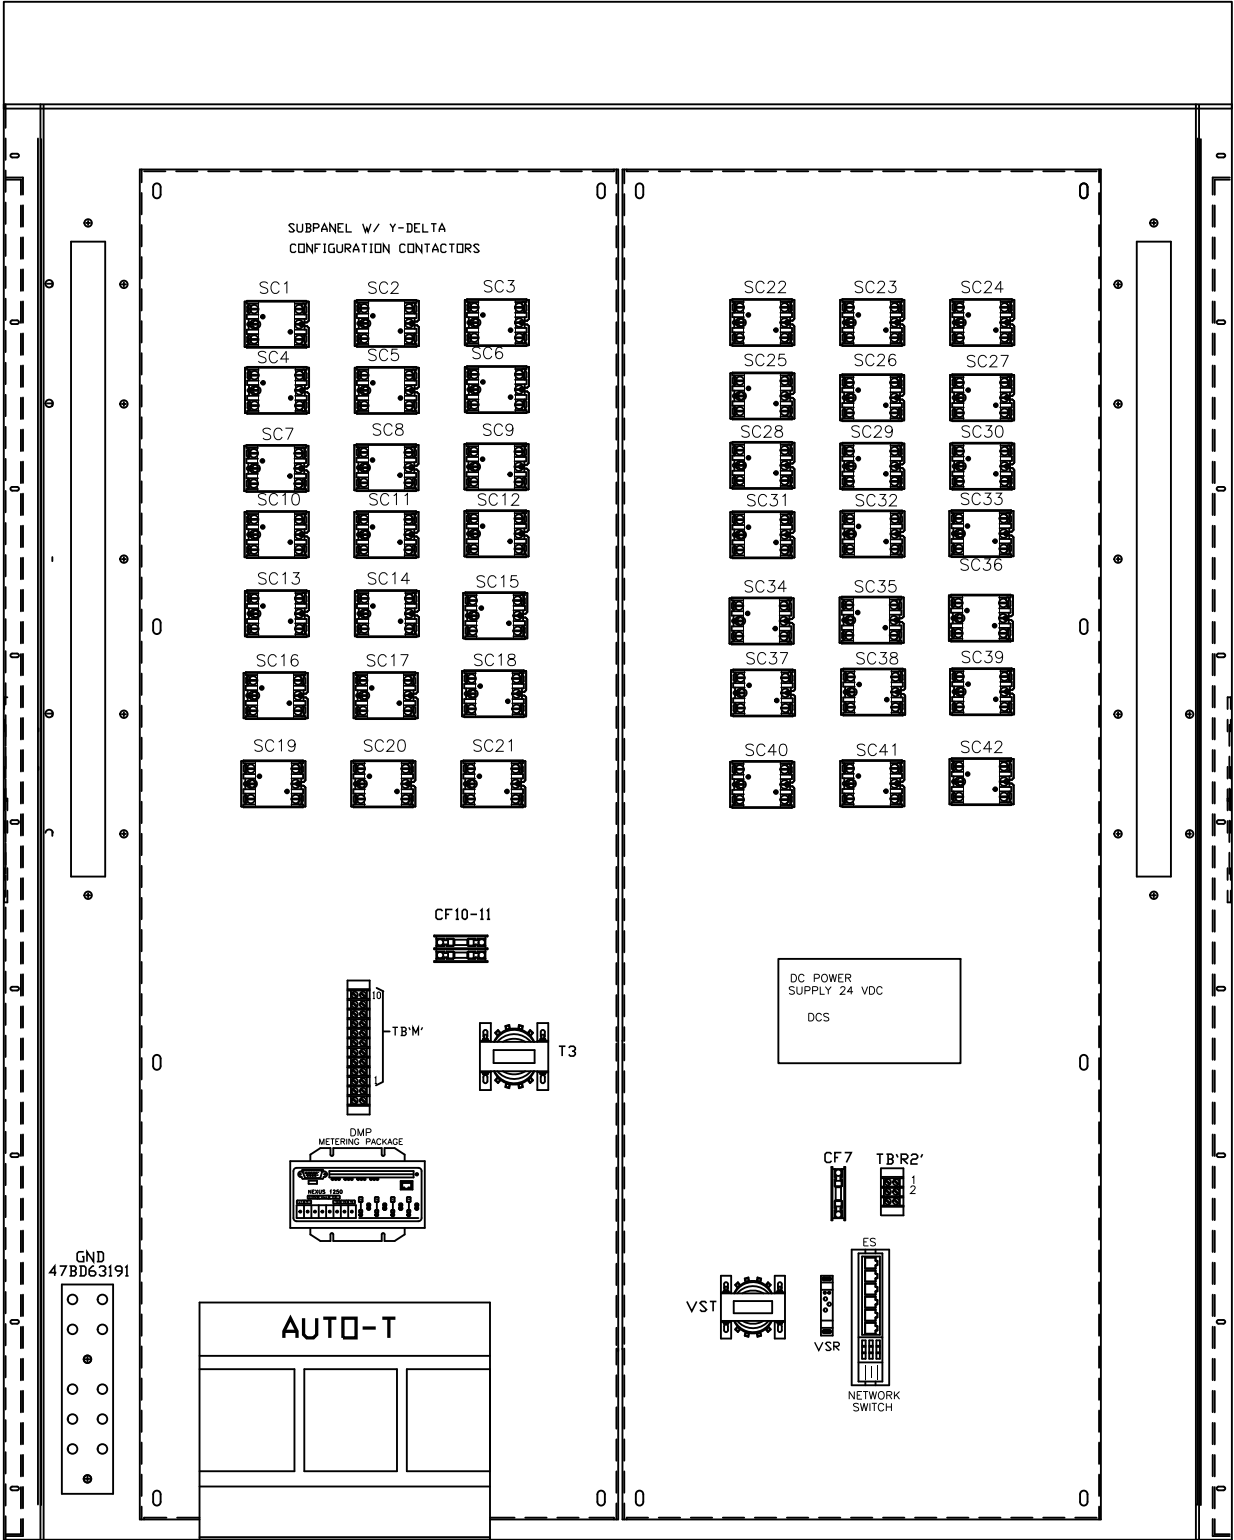

FLOOR  
MOUNTED

FRONT VIEW OF SUBPANEL BOX

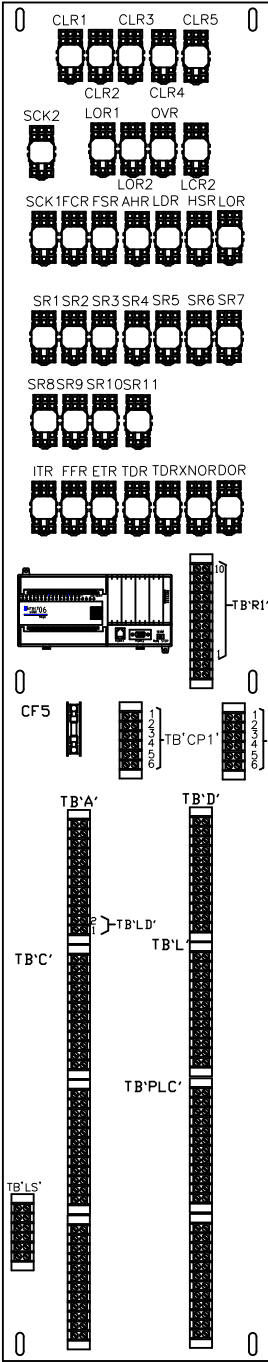

RIGHT SIDE  
SUBPANEL

THE INFORMATION HEREON IS THE PROPERTY OF SIMPLEX, INC., AND/OR ITS SUBSIDIARIES. WITHOUT WRITTEN PERMISSION ANY COPYING, TRANSMITTAL TO OTHERS AND USE EXCEPT THAT FOR WHICH IT IS LOANED IS PROHIBITED.

© 2007 SIMPLEX INC., ALL RIGHTS RESERVED

ARRANGED AS BUILT	DRAWN BY : AZM
RE-ARRANGED COMPONENTS	DATE : 4/2/07
DATE : 3/23/07	DRAWN BY : JPC
DATE : 3/29/07	REV:
SIMPLX® SPRINGFIELD, ILLINOIS	
SCALE:	APPROVED BY :
DATE : 3/23/07	DATE : 3/29/07
RESISTIVE LOAD BANK	SATURN-3000 DY
2550KW/3000KW,480/600V,3Ø,60HZ	SUBPANEL 2
W.O.# 63798-07-43/2	DRAWING NUMBER 47BD164483B